


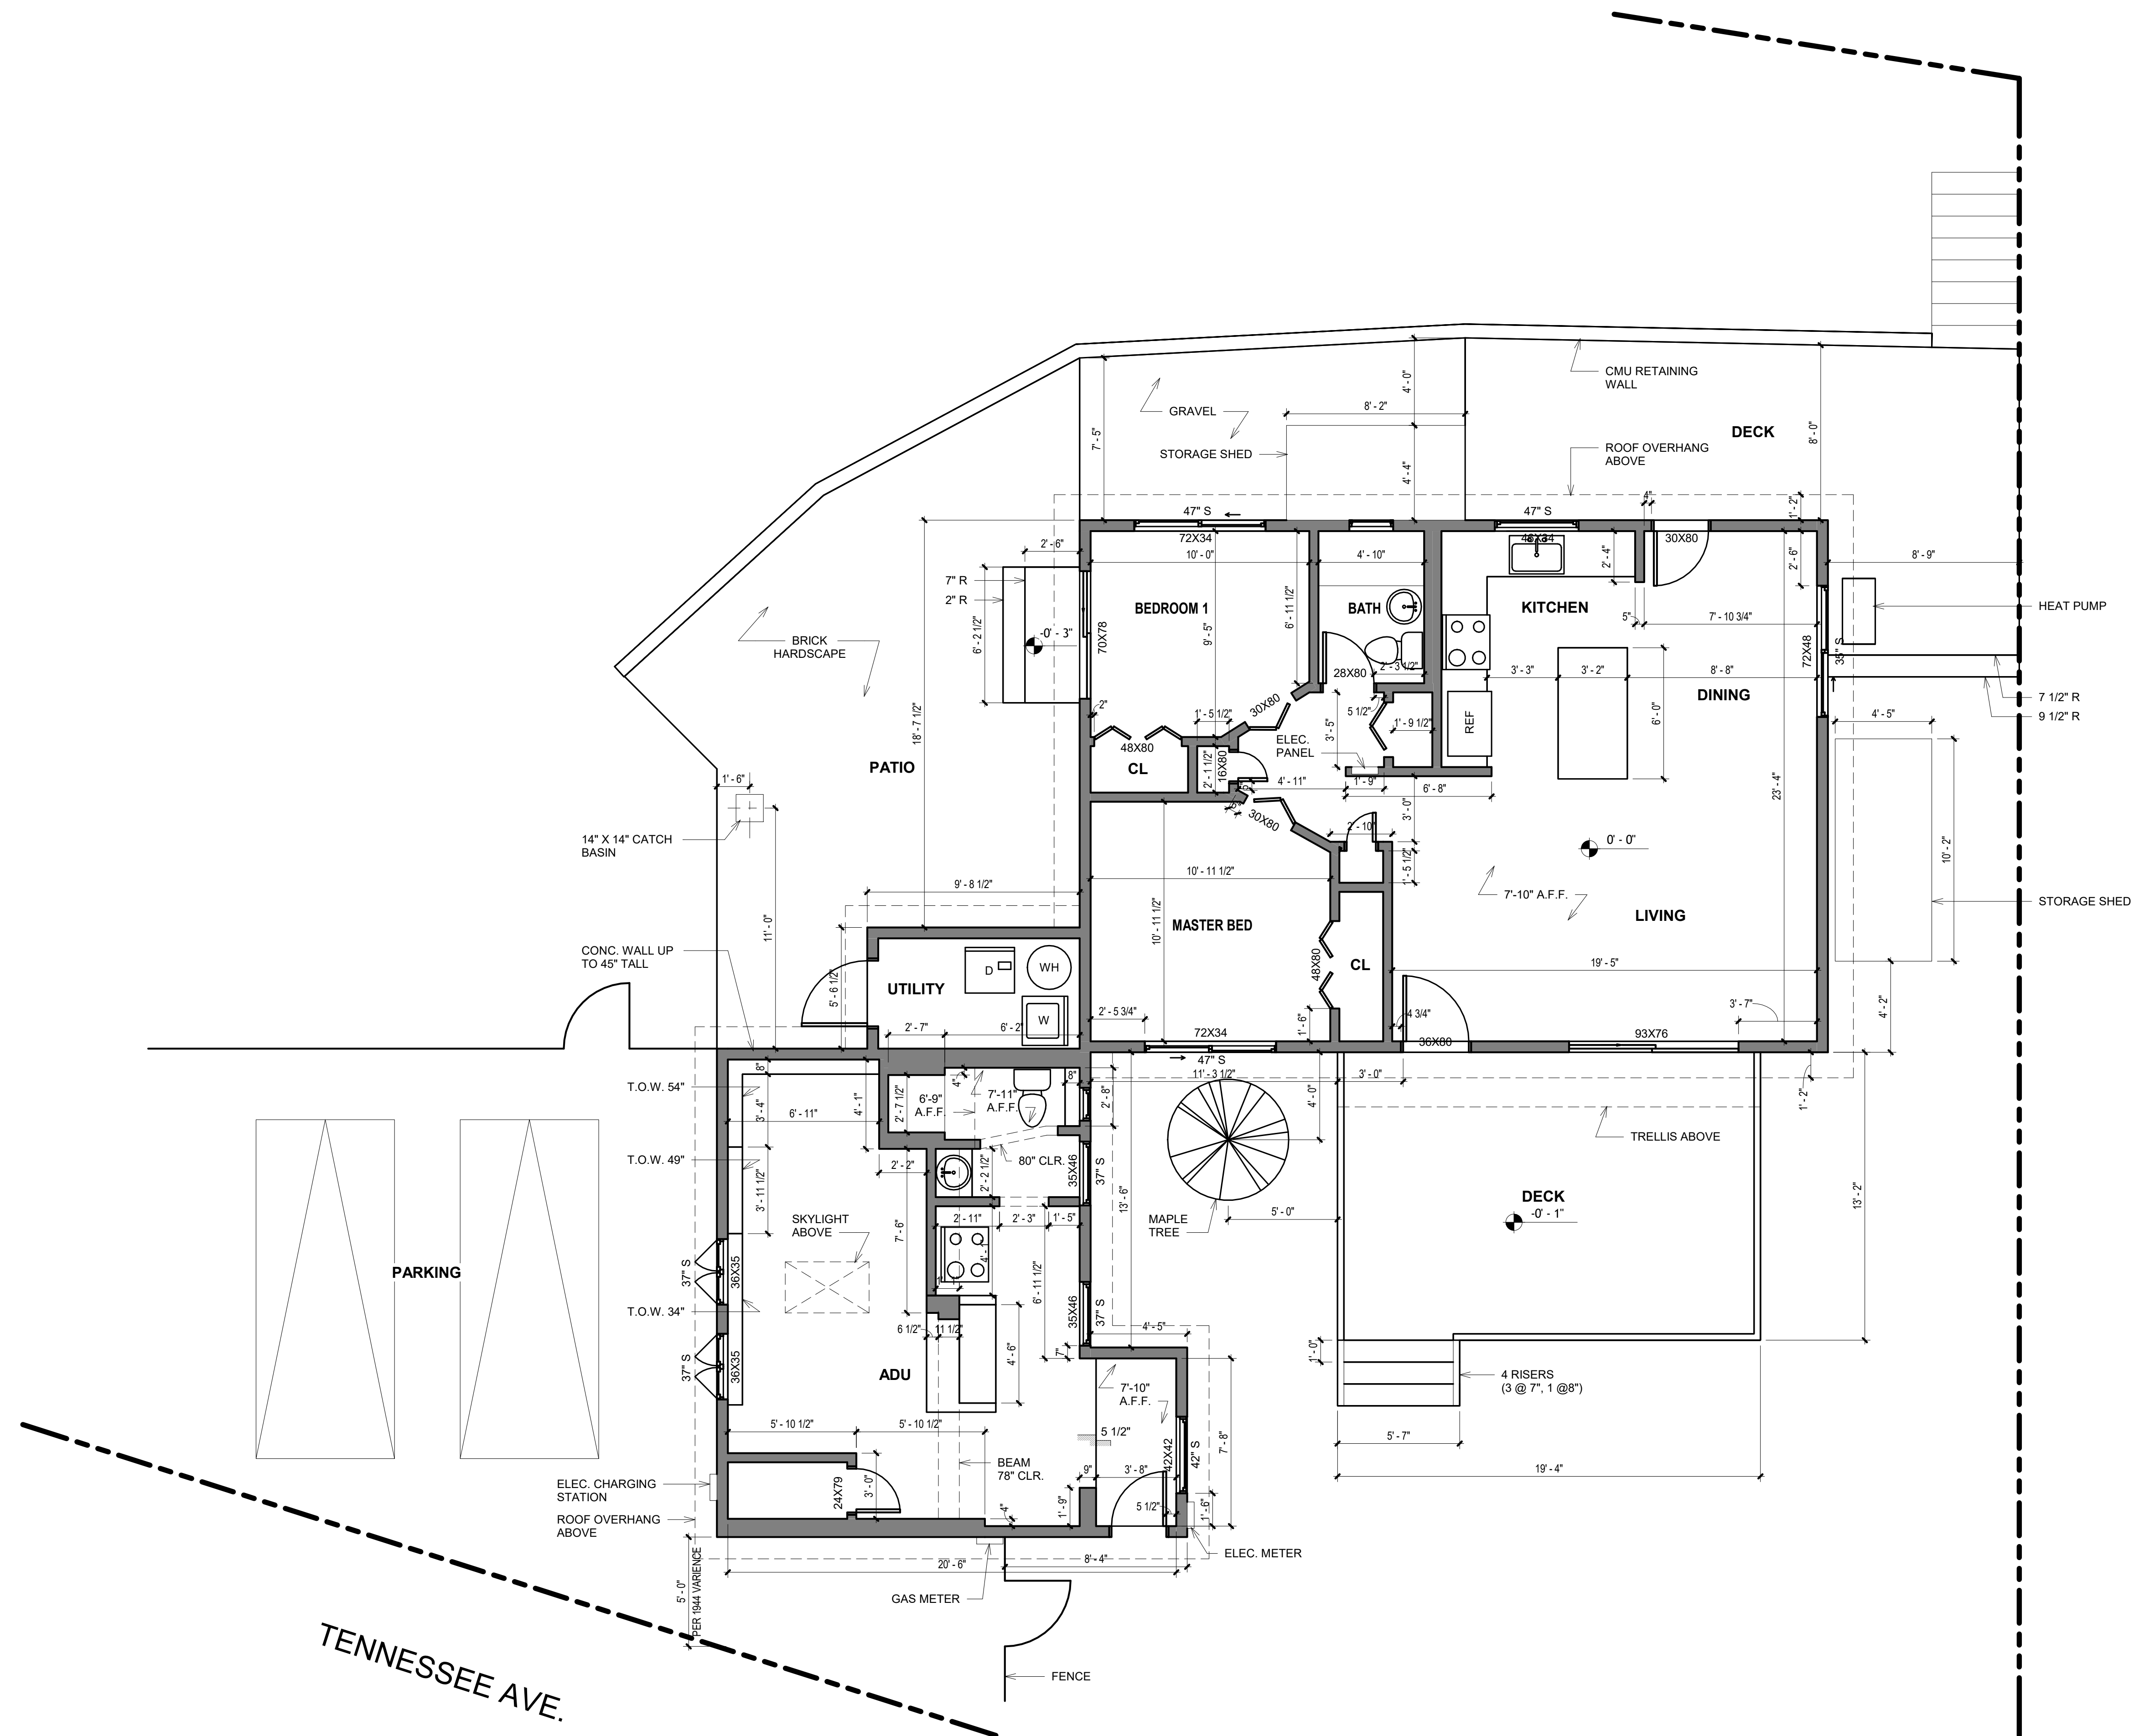

AS-BUILT DRAWINGS

LOMAN MCNAMARA

100 Tamalpais Road, Berkeley CA 94708
TEL: 717.799.4078
EMAIL: richard@lomanmcnamara.com
ill@lomanmcnamara.com

HUCKSTEPP / TAISTRA

310 TENNESSEE AVE.
MILL VALLEY, CA 94941

EXISTING FLOOR PLAN

AS1.0

Scale 1/4" = 1'-0"